


0 100

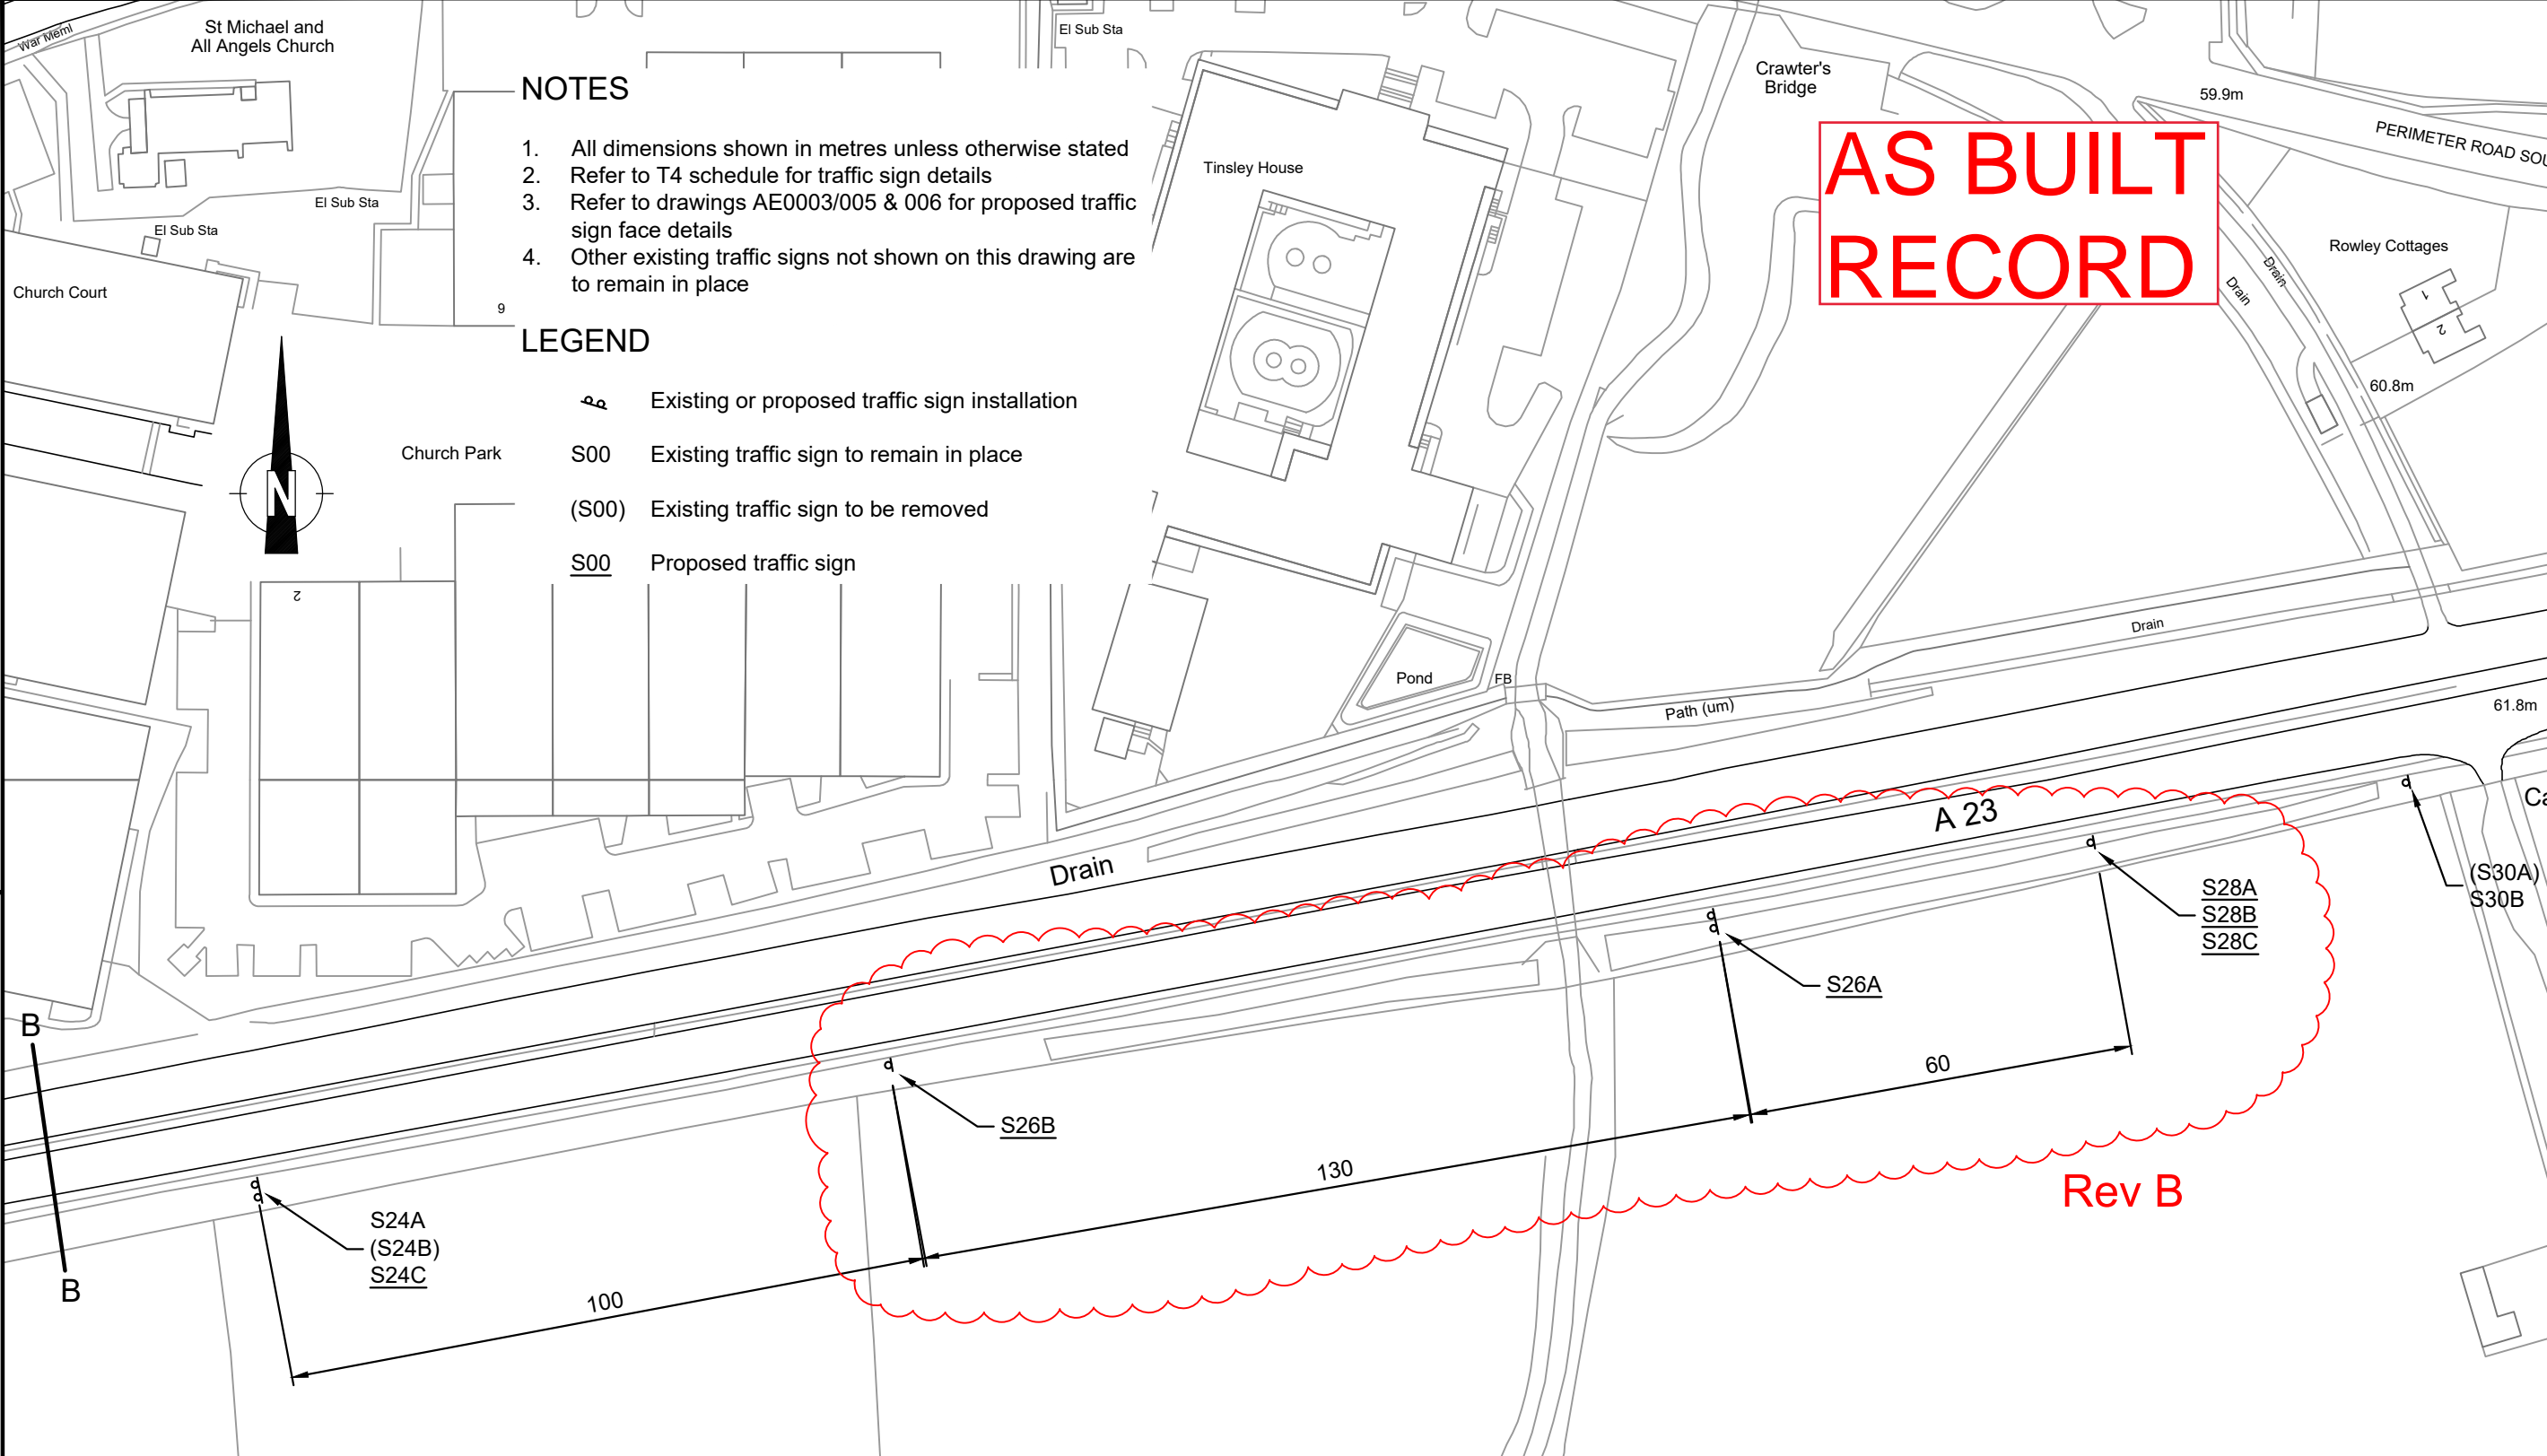


AS BUILT RECORD

NOTES

1. All dimensions shown in metres unless otherwise stated
2. Refer to T4 schedule for traffic sign details
3. Refer to drawings AE0003/005 & 006 for proposed traffic sign face details
4. Other existing traffic signs not shown on this drawing are to remain in place

LEGEND

- Existing or proposed traffic sign installation
- S00 Existing traffic sign to remain in place
- (S00) Existing traffic sign to be removed
- S00 Proposed traffic sign

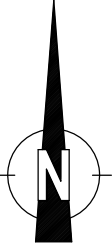

-	-	-	-	-
B	MOVE_S26A&S28	-	-	2/12/20
A	REVISED_S24	-	-	8/01/20
Rev	Revision details	Chkd	Appd	Date
Drawn:	DNJ	✓		For comment
Chkd:	-			For tender
Appd:	-			For construction
Date:	23/09/2019			As constructed
File ref: G:\PROJECTS\IWP Ref: N/A				

West Sussex County Council
 Infrastructure Group
 County Hall,
 West Street
 Chichester
 West Sussex
 PO19 1RH
 (01243) 642105

west sussex county council

Project Name
LOWFIELD HEATH ROUNDABOUT CRAWLEY

Drawing Title
ROAD SAFETY IMPROVEMENTS TRAFFIC SIGN WORKS INSET C

REPRODUCED FROM 2017 ORDNANCE SURVEY MASTER MAPPING WITH THE PERMISSION OF THE CONTROLLER OF HER MAJESTY'S STATIONERY OFFICE CROWN COPYRIGHT. UNAUTHORISED REPRODUCTION INFRINGES CROWN COPYRIGHT AND MAY LEAD TO PROSECUTION OR CIVIL PROCEEDINGS. LICENCE No. W.S.C.C. 100023447

Original Drawing Size : A3
 Scale : 1:1000 Dimensions : -

Drawing No
AE0003/004

Rev
B